LABOR AND MATERIALS

1	Copper ~~Lead~~ Connection 3/4	$ 1.31
1	Curb { Cock ~~Valve~~ ~~Tr. S. & Vr.~~ } 3/4 in.	$ 1.75
1	Service Box Old returned { ~~Short 3½x4½~~ Long 4½x5½ ~~Buff. or Rdway~~ }	$ 1.60
9	Ft. 3/4 in. { Copper ~~Galv Iron~~ ~~Cast Iron~~ } Pipe at 18	$ 1.62
	Nipples ____ in. at	$
	Bushings ____ to ____ in. at	$
	Red'g Inc'g } Couplings ____ to ____ in. at	$
	Union ____ in. at	$
	Meter ____ in. at	$
	Lead Joints at	$
	Leadite Joints at	$
	Hrs. Foreman at	$
7	Hrs. Chauffeur at 62½	$ 4.38
	Hrs. Tapper at	$
10	Hrs. Labor at 45	$ 4.50
	Hrs. Labor at	$
	Hrs. Compressor at	$
	Compensation Ins.	$ .27
	Trucking	$ 1.—
	Builders Use of Water Patch	$ 5.—
	Tap by Miller	$
		$
		$
		$
		$ 21.43

8 5 - - 1940

St. ~~Pl.~~ Ave. No. 30

Fulton

Name of Owner

Moran

Labor and Mat'l. Report Aug 9 1940

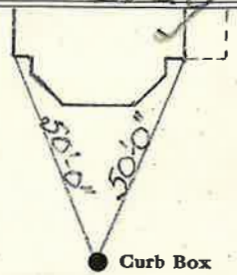

10" Main

Elev. of Main at tap 5'

Gate at ● ● Gate at

TAX ID # 302.16-21-23

● Curb Box

41