LABOR AND MATERIALS

1	Copper / ~~Lead~~ Connection 3/4	$ 2.87
1	Curb { Cock / ~~Valve~~ / ~~T. S. & V.~~ } 3/4 in.	$ 3.62
1	Service box { Short 3½X4½ / Long ~~4½X5½~~ / ~~Buff or Rdway~~ } Old returned	$ 4.8
12	Ft. 3/4 in. { Copper / ~~G. I.~~ / ~~C. I.~~ } Pipe at 32	$ 3.84
	Nipples ..... in. at	$
	Bushings ..... to ..... in. at	$
	Red'g / Inc'g { Coupl'gs ..... to ..... in. at	$
	Union ..... in. at	$
	Meter ..... in. at	$
	Lead Joints at	$
	Compound Joints at	$
3	Hrs. Water Maint. Man—1 at 1.12	$ 3.36
3	Hrs. Water Maint. Man—2 at 1.02	$ 3.06
7	Hrs. Labor— ....at 91	$ 6.37
	Hrs. Labor— ....at	$
	Hrs. Compressor at	$
	Compensation Ins. at $ 2.15 per C	$ 0.28
	Trucking	$ 2.00
	Pav't Patch	$
	Top 4 Repairs	$
	0	$
		$
	O'head	$
		$ 30.08

65

St.
Fulton Pl. Ave. No. 4

Name of Owner

Angelson

Labor and Mat'l. Report June 24 1909

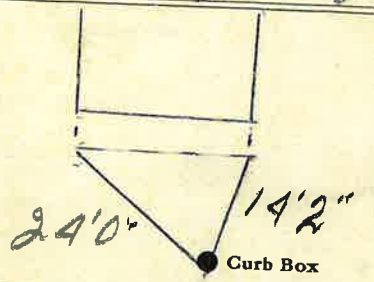

10 11 1
Main
Elev. of Main at tap 5

Gate at ●
● Gate at

● Curb Box

LSM-5C 5 15-48 Take Billard