## LABOR AND MATERIALS

| | | | |
|---|---|---|---|
| 1 | Copper / ~~Lead~~ Connection | 3/4 | $ 1.23 |
| 1 | Curb { Cock / ~~Valve~~ / ~~T. S. & V.~~ } | 3/4 in. | $ 1.68 |
| 1 | Service Box / ~~Old returned~~ { Short 3½x4½ / Long 4½x5½ / ~~Buff. or Rdway~~ } | | $ 1.54 |
| 23 | Ft. 3/4 in. { Copper / ~~Galv Iron~~ / ~~Cast Iron~~ } Pipe at 17 | | $ 3.91 |
| | Nipples ____ in. at | | $ |
| | Bushings ____ to ____ in. at | | $ |
| | Red'g / Inc'g } Couplings ____ to ____ in. at | | $ |
| | Union ____ in. at | | $ |
| | Meter ____ in. at | | $ |
| | Lead Joints at | | $ |
| | Leadite Joints at | | $ |
| | Hrs. Foreman at | | $ |
| 3 | Hrs. Chauffeur at | 62½ | $ 1.88 |
| 8 | Hrs. Tapper at | " | $ 5.00 |
| 8 | Hrs. Labor at | 45 | $ 3.60 |
| | Hrs. Labor at | | $ |
| | Hrs. Compressor at | | $ |
| | Compensation Ins. | | $ .32 |
| | Trucking | | $ 1.00 |
| | Builders Use of Water | Patch | $ 5.00 |
| | Taply Hensel | | $ |
| | | | $ |
| | | | $ |
| | | | $ |
| | | | $ 25.16 |

86 - - 1939

St.
~~Pl.~~
Fulton Ave. No. 7-7A

Name of Owner

St. John

Labor and Mat'l. Report Oct 24 1939

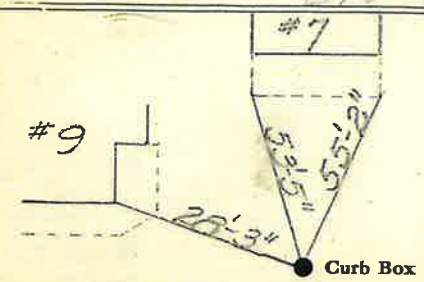


10" Main

Elev. of Main at tap 6'

Gate at ●

● Gate at

● Curb Box

TM