GAGE

Ave. No. 29

Name of Owner

EMMA WASHBURN

Labor and Mat'l. Report 19 37, MAY 7

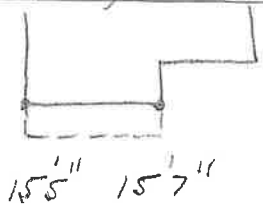

● Curb Box

4" Main

Elev. of Main at tap 5 1/2'

Gate at ●

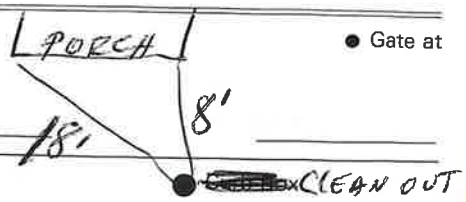

● Gate at

OLD SHUT OFF

OUT SIDE CLEAN-OUT.

NEW LINE to the MAIN

INSTALLED 4/8/2010

LABOR AND MATERIALS

1	Copper ~~Lead~~ Connection 3/4		$
1	Curb Cock ~~Valve~~ ~~T.S. & V.~~ 3/4 in.		$
1	Service box Old returned ~~Short 3-1/2 x 4-1/2~~ Long 4-1/2 x 5-1/2		$
13	Ft. 3/4 in. Copper Pipe at		$
	Nipples	in. at	$
	Bushings	to in. at	$
	Red'g		
	Inc'g		
	Union	in. at	$
	Meter	in. at	$
			$
	Compound Joints at		$
	Maintenance Foreman		$
	Hrs. Water Maint. Man - 1 at		$
	Hrs. Water Maint. Man - 2 at		$
	Hrs. Garage Foreman	at	$
	Hrs. Labor	at	$
	Hrs. Compressor at		$
			$
	Trucking		$
	Pav't Patch		$
			$
			$
			$
			$
			$