GAGE ~~St.~~ ~~Pl.~~ Ave. No. 32

Name of Owner

MARY CALLAHAN

Labor and Mat'l. Report 1937, MAY 5

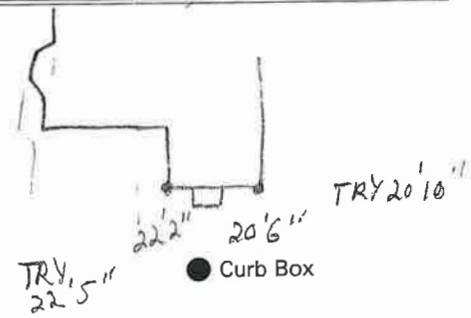

4" Main

Elev. of Main at tap 6'

Gate at ●

● Gate at

TAX ID # 302.16-11-7

● Curb Box

OLD SHUT OFF

ELBOWS 5' OFF RIGHT SIDE OF HOUSE

LABOR AND MATERIALS

1 Copper / ~~Lead~~ } Connection 3/4 $ ____

1 Curb } Cock / ~~Valve~~ / ~~T.S. & V.~~ } 3/4 in. ____ $ ____

1 Service box Old returned { ~~Short 3-1/2 x 4-1/2~~ / Long 4-1/2 x 5-1/2 } ____ $ ____

26 Ft. 3/4 in. { Copper / ~~Gal.~~ / ~~Oil~~ } Pipe at ____ $ ____

____ Nipples ____ in. at ____ $ ____

____ Bushings ____ to ____ in. at ____ $ ____

____ Red'g

____ Inc'g

____ Union ____ in. at ____ $ ____

____ Meter ____ in. at ____ $ ____

____ ____ $ ____

____ Compound Joints at ____ $ ____

____ Maintenance Foreman ____ $ ____

____ Hrs. Water Maint. Man - 1 at ____ $ ____

____ Hrs. Water Maint. Man - 2 at ____ $ ____

____ Hrs. Garage Foreman ____ at ____ $ ____

____ Hrs. Labor ____ at ____ $ ____

____ Hrs. Compressor at ____ $ ____

____ ____ $ ____

____ Trucking ____ $ ____

____ Pav't Patch ____ $ ____

____ ____ $ ____

____ ____ $ ____

____ ____ $ ____

____ ____ $ ____

$ ____