Sage St: 33
Ave. No. 19

Name of Owner
Willard C. Miller

Labor and Mat'l. Report 6/9/20 19

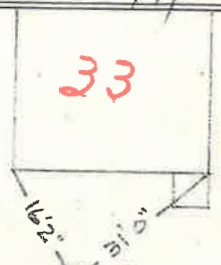

BOX INSIDE WALK ● Curb Box

4" Main Elev. of Main at tap 6'

Gate at ● ● Gate at

TAX ID # 302.16-12-25

● Curb Box

Labor and Materials

Copper Lead { Connection ..... $
Curb { Cock / Valve / T. S. & V. } ..... in ..... $
1 Service Box { ~~Short 4½ x 4½~~ / Long 4½ x 5½ / ~~Ruff on Rdwy~~ } Old returned ..... $
15 Ft. 3/4 in. { ~~Copper~~ / Galv Iron / ~~Cast Iron~~ } Pipe at ..... $
Nipples ..... in. at ..... $
Bushings ..... to ..... in. at ..... $
Red'g Inc'g { Conplings ..... to ..... in. at ..... $
Union ..... in. at ..... $
Meter ..... in. at ..... $
Lead Joints at ..... $
Leadite Joints at ..... $
Hrs. Foreman at ..... $
Hrs, Chauffeur at ..... $
Hrs. Tapper at ..... $
Hrs. Labor at ..... $
Hrs. Labor at ..... $
Hrs. Compressor at ..... $
Compensation Ins. ..... $
Trucking ..... $
Builders Use of Water ..... $
..... $
..... $
..... $
..... $
$