GAGE

~~St.~~
~~Pl.~~ Ave. No. 36

Name of Owner

HENRY KELLEY

Labor and Mat'l. Report 1937, APR. 30

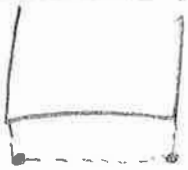

27'4" 12'7"

● Curb Box

4" Main

Elev. of Main at tap 6'

Gate at ●

● Gate at

TAX ID # 302.16-11-9

● Curb Box

OLD SHUT OFF

LABOR AND MATERIALS

1 Copper / ~~Lead~~ } Connection 3/4 $ _____

1 Curb { Cock / ~~Valve~~ / ~~T.S.&V.~~ } 3/4 in. _____ $ _____

1 Service box Old returned { ~~Short 3-1/2 x 4-1/2~~ / Long 4-1/2 x 5-1/2 } _____ $ _____

25 Ft. 3/4 in. { Copper / ~~Cl.~~ / ~~Cl.~~ } Pipe at _____ $ _____

_____ Nipples _____ in. at _____ $ _____

_____ Bushings _____ to _____ in. at _____ $ _____

_____ Red'g

_____ Inc'g

_____ Union _____ in. at _____ $ _____

_____ Meter _____ in. at _____ $ _____

_____ _____ $ _____

_____ Compound Joints at _____ $ _____

_____ Maintenance Foreman _____ $ _____

_____ Hrs. Water Maint. Man - 1 at _____ $ _____

_____ Hrs. Water Maint. Man - 2 at _____ $ _____

_____ Hrs. Garage Foreman _____ at _____ $ _____

_____ Hrs. Labor _____ at _____ $ _____

_____ Hrs. Compressor at _____ $ _____

_____ _____ $ _____

_____ Trucking _____ $ _____

_____ Pav't Patch _____ $ _____

_____ _____ $ _____

_____ _____ $ _____

_____ _____ $ _____

_____ _____ $ _____

$ _____