LABOR AND MATERIALS

_____ Copper / Lead } Connection _____ $_____

_____ Curb { Cock / Valve / T.S. & V. } _____ in. _____ $_____

_____ Service box / Old returned { Short 3-1/2 x 4-1/2 / Long 4-1/2 x 5-1/2 } _____ $_____

_____ Ft. _____ in. { Copper / G.I. / C.I. } Pipe at _____ $_____

_____ Nipples _____ in. at _____ $_____

_____ Bushings _____ to _____ in. at _____ $_____

_____ Red'g

_____ Inc'g

_____ Union _____ in. at _____ $_____

_____ Meter _____ in. at _____ $_____

_____ _____ $_____

_____ Compound Joints at _____ $_____

_____ Maintenance Foreman _____ $_____

_____ Hrs. Water Maint. Man - 1 at _____ $_____

_____ Hrs. Water Maint. Man - 2 at _____ $_____

_____ Hrs. Garage Foreman _____ at _____ $_____

_____ Hrs. Labor _____ at _____ $_____

_____ Hrs. Compressor at _____ $_____

_____ _____ $_____

_____ Trucking _____ $_____

_____ Pav't Patch _____ $_____

_____ _____ $_____

_____ _____ $_____

_____ _____ $_____

_____ _____ $_____

$_____

St. 10 Arbor Dr. N.
Pl.
_____ Ave. No. _____

Name of Owner

Labor and Mat'l. Report ~~10~~ 6-13-16

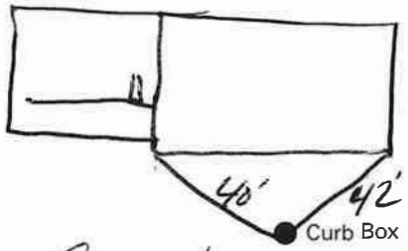

Sewer c/o

_____ Main

Elev. of Main at tap _____

Gate at ●

● Gate at

● Curb Box

Tax ID# 302.11-6-24