LABOR AND MATERIALS

1 Copper / ~~Lead~~ } Connection 3/4 $

1 Curb } Cock / ~~Valve~~ / ~~T. S. & V.~~ } 3/4 in. $

1 Service box Old returned { Short 3½ x 4½ / Long 4½ x 5½ / Buff or Rdway } $

25 Ft. 3/4 in. { Copper / ~~C.I.~~ / ~~C.I.~~ } Pipe at $

Nipples in. at $

Bushings to in. at $

Red'g / Inc'g } Coupl'gs to in. at $

Union in. at $

Meter in. at $

Lead Joints at $

Compound Joints at $

Maintenance Foreman $

Hrs. Water Maint. Man—1 at $

Hrs. Water Maint. Man—2 at $

Hrs. Garage Foreman at $

Hrs. Labor— at $

Hrs. Compressor at $

Compensation Ins. at $ per C $

Trucking $

Pav't Patch $

$

$

$

O'head $

$

Lot 6 - 7 Block 14 Broad Acres

Lot 6-7.
Block 14
Broad Acres

~~St.~~ Pl. ~~Ave.~~ No.

ASHLEY

Name of Owner

Labor and Mat'l. Report Nov. 14 19 38

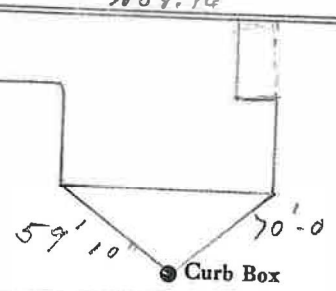

12 Main Elev. of Main at tap 4½'

Gate at ● ● Gate at

● Curb Box

LGM—5C—6-1-67