LABOR AND MATERIALS

1	Copper ~~Lead~~ Connection 3/4	$ 1.35
1	Curb Cock / ~~Valve~~ / T. S. & V. 3/4 in.	$ 1.88
1	Service Box Old returned Short 3½x4½ / ~~Long 4½x5½~~ / Buff. or Rdway	$ 1.82
26	Ft. 3/4 in. Copper / ~~Galv Iron~~ / Cast Iron Pipe at 20	$ 5.20
	Nipples ____ in. at	$
	Bushings ____ to ____ in. at	$
	Red'g / Inc'g Couplings ____ to ____ in. at	$
	Union ____ in. at	$
	Meter ____ in. at	$
	Lead Joints at	$
	Leadite Joints at	$
	Hrs. Foreman at	$
13	Hrs. Chauffeur at 6.83¼	$ 8.94
	Hrs. Tapper at	$
16	Hrs. Labor at .55	$ 8.80
	Hrs. Labor at	$
	Hrs. Compressor at	$
	Compensation Ins.	$ .54
	Trucking	$ 1.—
	Builders Use of Water Patch	$ 5.00
	Tap by Warsiaski	$
		$
		$
		$
		$ 34.53

H.

1912

~~Str.~~ Pl. ~~Ave.~~ No. 12 & B

Auburn 6 + 8

Name of Owner

Sweeney

Labor and Mat'l. Report May 18, 1942

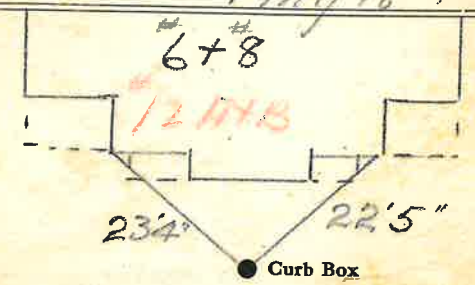

6" C.I. 1958

~~4" Cal~~ Main

Elev. of Main at tap 5½

Gate at ●

● Gate at

● Curb Box

H.