LABOR AND MATERIALS

1 ~~Copper Lead~~ Connection 3/4 $_____

1 Curb ~~Cock Valve T. S. & V.~~ 3/4 in. $_____

1 Service box ~~Short 3½ x 4½~~ Long 4½ x 5½ ~~Buff or Rdway~~ Old returned $_____

12 Ft. 3/4 in. ~~Copper G. I. C. I.~~ Pipe at $_____

Nipples ____ in. at ____ $_____

Bushings ____ to ____ in. at ____ $_____

Red'g Inc'g Coupl'gs ____ to ____ in. at ____ $_____

Union ____ in. at ____ $_____

Meter ____ in. at ____ $_____

Lead Joints at ____ $_____

Compound Joints at ____ $_____

Maintenance Foreman ____ $_____

Hrs. Water Maint. Man—1 at ____ $_____

Hrs. Water Maint. Man—2 at ____ $_____

Hrs. Garage Foreman ____ at ____ $_____

Hrs. Labor— ____ at ____ $_____

Hrs. Compressor at ____ $_____

Compensation Ins. at $____ per C $_____

Trucking ____ $_____

Pav't Patch ____ $_____

____ $_____

____ $_____

____ $_____

O'head ____ $_____

$_____

BAY St. Pl. Ave. No. 69

Name of Owner

Labor and Mat'l. Report 19

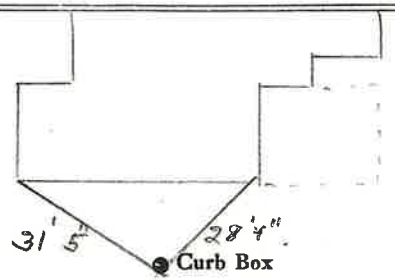

10" Main

Elev. of Main at tap 5

Gate at ●

● Gate at

● Curb Box

LSM—5C—6-1-67