LABOR AND MATERIALS

1 Copper / ~~Lead~~ } Connection 3/4 " $

1 Curb } Cock / ~~Valve~~ / ~~T. S. & V.~~ } 3/4 in. ORISEAL 3/4 $

1 Service box / ~~Old returned~~ } ~~Short 3½ x 4½~~ / Long 4½ x 5½ / ~~Buff or Rdway~~ $

12 Ft. 3/4 in. } Copper / ~~G. I.~~ / ~~C. I.~~ } Pipe at $

Nipples in. at $

Bushings to in. at $

Red'g / Inc'g } Coupl'gs to in. at $

Union in. at $

Meter in. at $

Lead Joints at $

Compound Joints at $

Maintenance Foreman $

Hrs. Water Maint. Man—1 at $

Hrs. Water Maint. Man—2 at $

Hrs. Garage Foreman at $

Hrs. Labor— at $

Hrs. Compressor at $

Compensation Ins. at $ per C $

Trucking $

Pav't Patch $

$

$

$

O'head $

$

BAY St. / Pl. / Ave. No. 157

Name of Owner

TAX ID # 302.16-7-8

Labor and Mat'l. Report 19

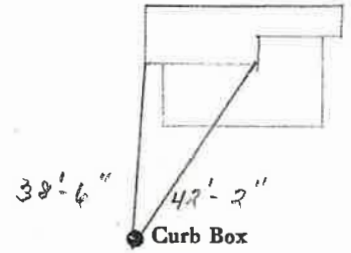

Main

Elev. of Main at tap

Gate at ●

● Gate at

12' to MAIN

● Curb Box

LSM—5C—6-1-67