LABOR AND MATERIALS

1	Copper Lead	Connection 3/4	$ 3.94
1	Curb { Clock Valve T. S. & V. }	3/4 in.	$ 3.71
1	Service box Old returned	{ Short 3½X4½ Long 4⅝X5½ Buff or Rdway }	$ 5.90
9 Ft. 3/4 in.	{ Copper Galv. Iron Cast Iron }	Pipe at 30	$ 2.70
	Nipples	in. at	$
	Bushings	to in. at	$
	Red'g Inc'g { Couplings	to in. at	$
	Union	in. at	$
	Meter	in. at	$
	Lead Joints at		$
	Compound Joints at		$
	Hrs. Foreman at		$
2	Hrs. ~~Chauffeur~~ at WMM-2 91		$ 1.82
	Hrs. Tapper at		$
6	Hrs. Labor at	80	$ 4.80
	Hrs. Labor at		$
	Hrs. Compressor at		$
	Compensation Ins.		$ .15
	Trucking		$ 1.00
	Builders Use of Water		$
	Tap 4 Watts Insk c'		$
			$
			$
			$
			$ 23.02

26

Wed

Bearss St — St. / Pl. / Ave. No. 52 — 10

Name of Owner

~~Corporation~~ PHILLIPS

Labor and Mat'l. Report April 20 19~~48~~

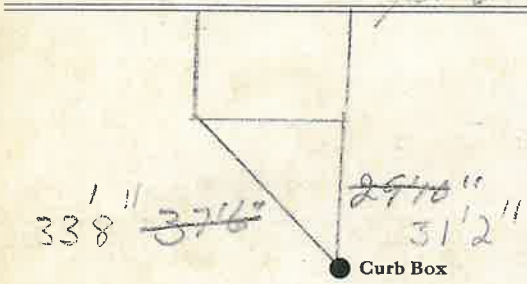

6" Main — Elev. of Main at tap 4

Gate at ● — ● Gate at

● Curb Box

LSM-5C-6-1-45