129-4T

West Beacon St. — St. / Pl. / Ave. No. 12

Name of Owner: Ross

Labor and Mat'l. Report — Jan 13 — 19 [illegible]

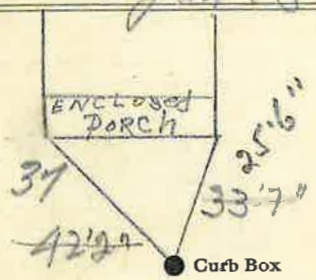

6 Main — Elev. of Main at tap 3-4

Gate at ● — ● Gate at

● Curb Box

TAX ID# 309.16-13-7

LSM-5C-6-1-45

LABOR AND MATERIALS

1	Copper Lead } Connection 3/4	$ 2.94
1	Curb { Clock Valve / T. S. & V. } 3/4 in.	$ 3.71
1	Service box Old returned { Short 3½X4½ / Long 4½X5½ / Buff or Rdway }	$ 5.90
~~8~~ 7	Ft. 3/4 in. { Copper / Galv. Iron / Cast Iron } Pipe at 30	$ 2.40
	Nipples in. at	$
	Bushings to in. at	$
	Red'g / Inc'g } Couplings to in. at	$
	Union in. at	$
	Meter in. at	$
	Lead Joints at	$
	Compound Joints at	$
	Hrs. Foreman at	$
1	Hrs. ~~Chauffeur at~~ W.M.M.-2 91	$ 91
	Hrs. Tapper at	$
	Hrs. Labor at	$
	Hrs. Labor at	$
	Hrs. Compressor at	$
	Compensation Ins.	$ .02
	Trucking	$ 1.00
	Builders Use of Water	$
	Tap by [illegible]	$
		$
		$
		$
		$ 16.88

SEWER

12 WEST BEACON

OUT SIDE CLEAN OUT

INSTALLED 3/19/2001

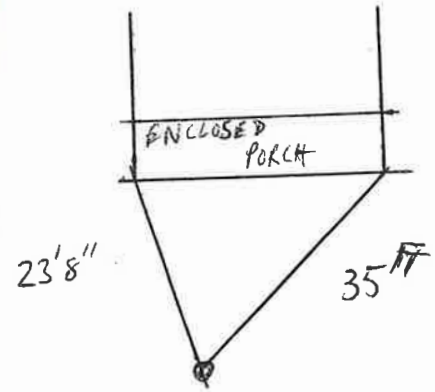

LOCATED NEXT TO DRIVEWAY.