LABOR AND MATERIALS

1	Copper / ~~Lead~~ Connection 3/4	$ 2.94
1	Curb { Cock / ~~Valve~~ / ~~T. S. & V.~~ } 3/4 in.	$ 3.71
1	Service box / ~~Old returned~~ { ~~Short 3½X4½~~ / Long 4½X5½ / ~~Buff or Rdway~~ }	$ 5.90
10	Ft. 3/4 in. { Copper / ~~G. I.~~ / ~~C. I.~~ } Pipe at 30	$ 3.00
	Nipples ..... in. at	$
	Bushings ..... to ..... in. at	$
	Red'g / Inc'g Coupl'gs ..... to ..... in. at	$
	Union ..... in. at	$
	Meter ..... in. at	$
	Lead Joints at	$
	Compound Joints at	$
	Hrs. Water Maint. Man—1 at	$
2	Hrs. Water Maint. Man—2 at 1.02	$ 2.04
	Hrs. Labor— .... at	$
	Hrs. Labor— .... at	$
	Hrs. Compressor at	$
	Compensation Ins. at $ ..... per C	$ .05
	Trucking	$ 1.00
	Pav't Patch	$
	Tap by Magnum	$
		$
		$
	O'head	$
		$ 18.64

150-41

East

Bea

St.
Pl.
Ave. No.

Name of Owner

Lord

Labor and Mat'l. Report Oct 22 19[illegible]

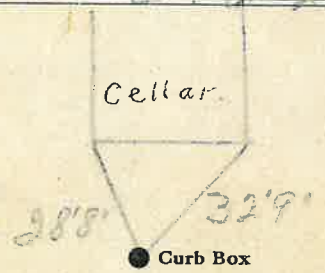

6" Main

Elev. of Main at tap 5

Gate at ●

● Gate at

● Curb Box

LSM-5C B 15-48