LABOR AND MATERIALS

1	Copper Lead — Connection	3/4	$ 1.79
1	Curb — Clock / Valve / T. S. & V.	3/4 in.	$ 2.61
1	Service box Old returned — Short 3½X4½ / Long 4½X5½ / Buff or Rdway		$ 1.82
8	Ft. 3/4 in. — Copper / Galv. Iron / Cast Iron — Pipe at 23		$ 1.84
	Nipples ... in. at		$
	Bushings ... to ... in. at		$
	Red'g / Inc'g — Couplings ... to ... in. at		$
	Union ... in. at		$
	Meter ... in. at		$
	Lead Joints at		$
	Compound Joints at		$
	Hrs. Foreman at		$
2	Hrs. Chauffeur at	$2½	$ 1.65
	Hrs. Tapper at		$
6	Hrs. Labor at	71½	$ 4.29
	Hrs. Labor at		$
3	Hrs. Compressor at	87½	$ 2.63
	Compensation Ins.		$ .16
	Trucking		$ 1.—
	Builders Use of Water		$
	Tap by Warsinski		$
			$
			$
			$
			$ 17.79

97-116
West 4
Beacon
St. [illegible]
Pl. [illegible]
Ave. No. 42

Name of Owner
(10) Blair (Charles)

Labor and Mat'l. Report Nov 14 1946

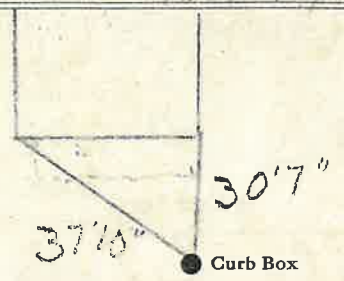

6 Main
Elev. of Main at tap 5

Gate at ● ● Gate at

● Curb Box

LSM-5C-6-1-45