LABOR AND MATERIALS

1	Copper / ~~Lead~~ Connection	3/4	$ 2.29
1	Curb { ~~Cock~~ / ~~Valve~~ / ~~T. S. & V.~~ }	3/4 in.	$ 2.70
1	Service box / Old returned { Short 3½x4½ / Long 4½x5½ / ~~Buff or Rdway~~ }		$ 4.25
27	Ft. 3/4 in. { ~~Copper~~ / ~~G. I.~~ / ~~C. I.~~ } Pipe at 35		$ 9.45
	Nipples in. at		$
	Bushings to in. at		$
	Red'g / Inc'g { Coupl'gs to in. at		$
	Union in. at		$
	Meter in. at		$
	Lead Joints at		$
	Compound Joints at		$
	Hrs. Water Maint. Man—1 at		$
16	Hrs. Water Maint. Man—2 at	1.02½	$ 16.32
27	Hrs. Labor— at	91	$ 24.57
	Hrs. Labor— at		$
	Hrs. Compressor at		$
	Compensation Ins. at $ per C.		$ 91
	Trucking		$ 1.—
	Pav't Patch		$ 13.50
	Tap by Warsinski		$
			$
			$
	O'head		$
			$ 74.99


Name of Owner

Kingsley

Labor and Mat'l. Report May 17 19 50

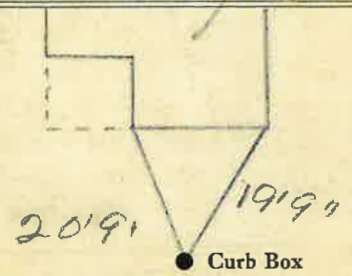

6 Main

Elev. of Main at tap 6

Gate at ●

● Gate at

TAX ID # 302.15-3-2

● Curb Box

LSM-5C 10-21-49