Labor and Materials

1	Copper / Lead	Connection 3/4	$3.20
1	Curb { Cock / ~~Valve~~ / ~~T. S. & V.~~ }	3/4" in.	$1.00
1	Service Box Old returned { ~~Short 3½ x 4½~~ / ~~Long 4½ x 5½~~ / ~~Buff. or Rdway~~ }		$1.40
39	Ft. 3/4 in. { Copper / Galv. Iron / Cast Iron } Pipe at		$5.58
	Nipples in. at		$
1	Bushings 3/4 to 1/2 in. at		$.08
1	Red'g Inc'g } Couplings 3/4 to Broad in. at		$.15
	Union in. at		$
	Meter in. at		$
	Lbs. Br. Stone at		$
	Lbs. Sand at		$
	Bags Cement at		$
	Paving Brick { Mack / Red / Asphalt } at		$
	Lead Joints at		$
	Leadite Joints at		$
7	Hrs. Foreman at 6.25		$4.38
24	Hrs. Common Labor at 5.0		$12.00
14	Hrs. Common Labor at ~~4.57~~		$4.06
	Hrs. Mason at		$
	Hrs Mason's Helper at		$
	Hrs. Compressor at		$
	Compensation Ins.		$ .55
	Trucking		$1.00
	Builders' Use of Water		$
		Total	$36.40
	Pmt Patch		3.00
			39.40

Labor and Material Report Aug 28 19 26

60 Broad

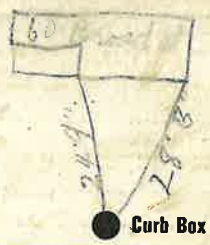

6" Main

Elev. of Main at tap 6' 11"

Gate at ● ● Gate at

● Curb Box

Edgar Hunter

Shut off at Curb

1-21-75