LABOR AND MATERIALS

1 Copper / Lead } Connection 3/4" $

1 Curb { Cock / Valve / T. S. & V. } 3/4 in. $

1 Service box / Old returned { Short 3½ x 4½ / Long 4½ x 5½ / Buff or Rdway } $

9 Ft. 3/4 in. { Copper / G. I. / C. I. } Pipe at $

Nipples in. at $

Bushings to in. at $

Red'g / Inc'g } Coupl'gs to in. at $

Union in. at $

Meter in. at $

Lead Joints at $

Compound Joints at $

Maintenance Foreman $

Hrs. Water Maint. Man—1 at $

Hrs. Water Maint. Man—2 at $

Hrs. Garage Foreman at $

Hrs. Labor— at $

Hrs. Compressor at $

Compensation Ins. at $ per C $

Trucking $

Pav't Patch $

Tap by Gissard + Co $

10-5-59 $

$

O'head $

$

✓

Broad St. / Pl. / Ave. No. 117

Name of Owner Berkowitz

Labor and Mat'l. Report Oct. 5 1959

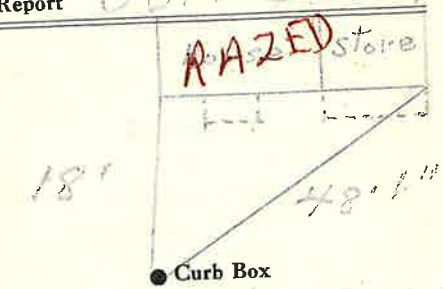

● Curb Box

6" Main

Elev. of Main at tap 5½'

Gate at ●

● Gate at

● Curb Box

LSM—5C—2-5 56