LABOR AND MATERIALS

1	Copper Lead } Connection 3/4	$ 1.35
1	Curb { Cock Valve T. S. & V. } 3/4 in.	$ 1.80
1	Service Box Old returned { Short 3⅛x4⅛ Long 4⅛x5⅛ Buff or Rdway }	$ 1.70
25	Ft. 3/4 in. { Copper Galv Iron Cast Iron } Pipe at 18	$ 4.50
	Nipples ... in. at	$
	Bushings ... to ... in. at	$
	Red'g Inc'g } Couplings ... to ... in. at	$
	Union ... in. at	$
	Meter ... in. at	$
	Lead Joints at	$
	Leadite Joints at	$
	Hrs. Foreman at	$
7	Hrs. Chauffeur at 62½¢	$ 1.25
5	Hrs. Tapper at "	$ 3.75
13½	Hrs. Labor at 45	$ 6.08
	Hrs. Labor at	$
	Hrs. Compressor at	$
	Compensation Ins.	$ .34
	Trucking	$ 1.—
	Builders Use of Water (Before Burning Tap by Hessel)	$
		$
		$
		$
		$
		$ 21.77

6 9 1941

St. #24
Pl.
Ave. No. 14

Broad

Name of Owner

Cunniff

Labor and Mat'l. Report June 13 1941

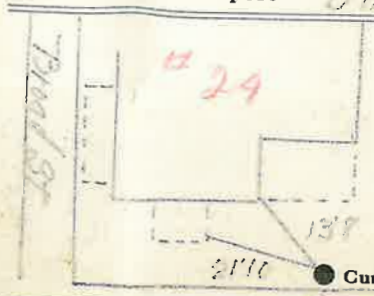

Top of main at tap

16 Main

Elev. of Main at tap 5

Gate at

Gate at

Curb Box

TAX ID #309.28-5-6

Lot 4 Blk