LABOR AND MATERIALS

1	Copper / ~~Lead~~ Connection 3/4"	$ 2.76
1	Curb { Cock / Valve / T. S. & V. } 3/4 in.	$ 3.49
1	Service box { Short 3½X4½ / Long 4½X5½ / Buff or Rdway } Old returned	$ 4.74
35 Ft.	3/4 in. { Copper / G. I. / C. I. } Pipe at 35	$ 12.25
	Nipples ... in. at	$
	Bushings ... to ... in. at	$
1	~~Red'g~~ / Inc'g Coupl'gs ... to 3/4 in. at	$
	Union ... in. at	$
	Meter ... in. at	$
	Lead Joints at	$
2	~~Compound Joints at~~ Fman 1.44	$ 2.88
13	Hrs. Water Maint. Man—1 at 1.34	$ 17.42
	Hrs. Water Maint. Man—2 at	$
28	Hrs. Labor— ... at 1.13	$ 31.64
	Hrs. Labor— ... at	$
6	Hrs. Compressor at 1.50	$ 9.00
	Compensation Ins. at $ 3.06 per C	$ 1.41
	Trucking	$ 1.00
	Pav't Patch	$ 22.95
		$
		$
		$
	O'head	$
		$ 109.55

8.66

Top mark July 2 52
by Warren Ed.

St.
Pl.
Broad Ave. No. 174

Name of Owner
Schwarts.

Labor and Mat'l. Report July 2 1952

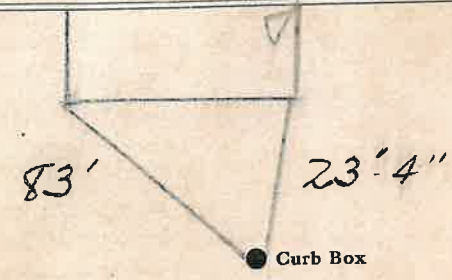

6" Main

Elev. of Main at tap -5'

Gate at

Gate at

Curb Box

LSM-SC 5 15-48