LABOR AND MATERIALS

1 Copper / ~~Lead~~ Connection 3/4" $

1 Curb { Cock / ~~Valve~~ / ~~T.C. & V.~~ } 3/4 in. (MARK II ORISEAL) $

1 Service box Old returned { ~~Short 3½ x 4½~~ / Long 4½ x 5½ / ~~Buff or Rdway~~ } $

25 Ft. 3/4 in. { Copper / ~~G.I.~~ / ~~C.I.~~ } Pipe at $

Nipples in. at $

Bushings to in. at $

Red'g / Inc'g Coupl'gs to in. at $

Union in. at $

Meter in. at $

Lead Joints at $

Compound Joints at $

Maintenance Foreman $

Hrs. Water Maint. Man—1 at $

Hrs. Water Maint. Man—2 at $

Hrs. Garage Foreman at $

Hrs. Labor— at $

Hrs. Compressor at $

Compensation Ins. at $ per C $

1 ~~Trucking~~ 6" Saddle $

Pav't Patch $

TAP MADE BY LAREDU + Co. $

O'head JUNE 20-1972 $

$

Broad ACRES Rd. ~~St.~~ ~~Pl.~~ ~~Ave.~~ No. 37

Name of Owner LaCroix

Labor and Mat'l. Report JUNE 20 1972

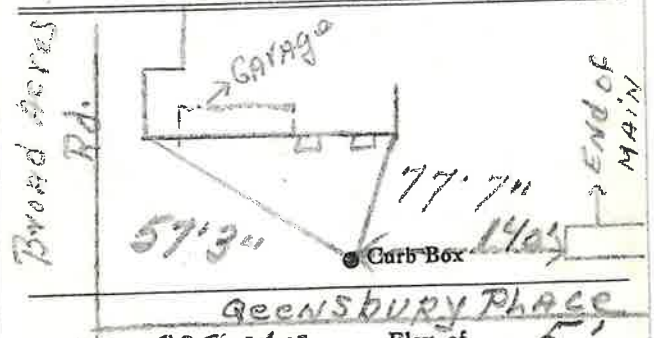

Queensbury Place

6" Main ASBESTOS CEMENT Elev. of Main at tap 5'

Gate at ● ● Gate at

TAP ON QUEENSBURY PL.

● Curb Box

LSM—5C—6-1-67