LABOR AND MATERIALS

1	Copper Lead Connection 3/4"	$ 2.76
1	Curb Cock Valve T. S. & V. 3/4 in.	$ 3.49
	Service box Old returned Short 3½X4½ Long 4½X5½ Buff or Rdway	$ 4.74
15	Ft. 3/4 in. Copper C. I. C. I. Pipe at 35	$ 5.25
	Nipples ... in. at	$
	Bushings ... to ... in. at	$
	Red'g Inc'g Coupl'gs ... to ... in. at	$
	Union ... in. at	$
	Meter ... in. at	$
	Lead Joints at	$
	Compound Joints at	$
8	Hrs. Water Maint. Man—1 at	$ 9.92
	Hrs. Water Maint. Man—2 at 1.24	$
36	Hrs. Labor— ... at 1.13	$ 40.68
	Hrs. Labor— ... at	$
	Hrs. Compressor at	$
	Compensation Ins. at $3.706 per C	$ 1.98
	Trucking	$ 1.00
	Pav't Patch	$
	Tap by Gifford 9-26-52	$
		$
		$
	O'head	$
		$ 70.72

Tap 89-1952

Bush St. Pl. Ave. No. 27

Name of Owner

Leon Peters

Labor and Mat'l. Report Sept 26 1952

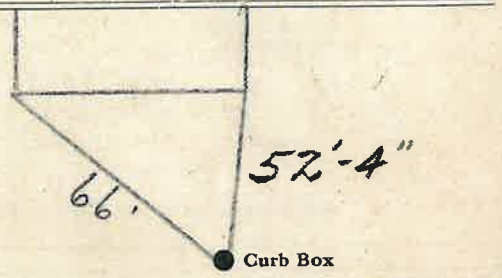

6" Main

Elev. of Main at tap 4[illegible]'

Gate at ● ● Gate at

● Curb Box

LSM-5C 5 15-48