LABOR AND MATERIALS

1 Copper / ~~Lead~~ } Connection 3/4" $

1 Curb { Cock / ~~Valve~~ / ~~T.S.&V.~~ } 3/4 in. OXISEAL $

1 Service box Old returned { ~~Short 3½ x 4½~~ / ~~Long 4½ x 5½~~ / ~~Buff or Rdway~~ } 2½' $

26 Ft. 3/4 in. { Copper / ~~G.I.~~ / ~~C.I.~~ } Pipe at $

Nipples in. at $

Bushings to in. at $

Red'g / Inc'g } Coupl'gs to in. at $

Union in. at $

Meter in. at $

1 ~~Lead Joints at~~ 1" x 3/4" Brass Coupling $

1 ~~Compound Joints at~~ 3/4" Male Adapter $

Maintenance Foreman $

Hrs. Water Maint. Man—1 at $

Hrs. Water Maint. Man—2 at $

Hrs. Garage Foreman at $

Hrs. Labor— at $

Hrs. Compressor at $

Compensation Ins. at $ per C $

Trucking $

Pav't Patch $

$

Tap By Purvis & Co $

July-6-1976 $

O'head $

$

Byrne ~~St.~~ ~~Rd.~~ Ave. No. 20

Name of Owner

Joesph Lovesque

Labor and Mat'l. Report July 6 1976

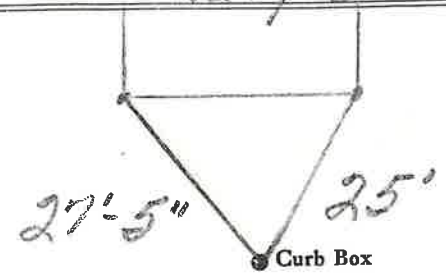

12" Main

Elev. of Main at tap 3½'

Gate at

Gate at

Curb Box

Tap on Side of Main

LSM—5C—6-1-67