LABOR AND MATERIALS

1 Copper ~~Lead~~ Connection	3/4	$ 1.23
1 Curb {Cock Valve ~~T. S. & V.~~}	3/4 in.	$ 1.68
1 Service Box Old returned {Short 3½x4½ ~~Long 4½x5½~~ ~~Buff. or Rdway~~}		$ 1.54
10 Ft. 3/4 in. {Copper ~~Galv Iron~~ ~~Cast Iron~~} Pipe at 17		$ 1.70
____ Nipples ____ in. at		$
____ Bushings ____ to ____ in. at		$
____ Red'g Inc'g Couplings ____ to ____ in. at		$
____ Union ____ in. at		$
____ Meter ____ in. at		$
____ Lead Joints at		$
____ Leadite Joints at		$
____ Hrs. Foreman at		$
6 Hrs. Chauffeur at 62½		$ 3.75
5 Hrs. Tapper at 45		$ 3.13
3 Hrs. Labor at 45		$ 1.35
____ Hrs. Labor at		$
____ Hrs. Compressor at		$
____ Compensation Ins.		$ .25
____ Trucking		$ 1.—
____ Builders Use of Water Patch		$ 5.—
Tap by Hessel		$
		$
		$
		$
		$20.63

7 3 — 1939 St.— #14
Pl.—
Cameron Ave. No. 10

Name of Owner
Frank Sullivan

Labor and Mat'l. Report Sept 11 1939

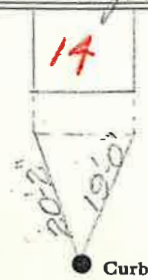

4 Main Elev. of Main at tap 4½

Gate at ● ● Gate at

TAX ID # 302.12-25-8

● Curb Box

FM
old shut off