LABOR AND MATERIALS

1	Copper ~~Lead~~ Connection	3/4	$ 1.78
1	Curb { Clock Valve T. S. & V. }	3/4 in.	$ 2.61
1	Service box Old returned { Short 3½X4½ Long 4½X5½ Buff or Rdway }		$ 1.87
10	Ft. 3/4 in. { Copper Galv. Iron Cast Iron } Pipe at 23		$ 2.30
	Nipples in. at		$
	Bushings to in. at		$
	Red'g Inc'g } Couplings to in. at		$
	Union in. at		$
	Meter in. at		$
	Lead Joints at		$
	Compound Joints at		$
6	Hrs. Foreman at	82½	$ 4.95
	Hrs. Chauffeur at		$
8	Hrs. Tapper at	71½	$ 5.720
	Hrs. Labor at		$
	Hrs. Labor at	87½	$ 88
1	Hrs. Compressor at		$ 29
	Compensation Ins.		$ 1.00
	Trucking	Patch?	$ 5.00
	Builders Use of Water.		$
	tapsy Warsinske		$
			$
			$
			$ 26.35

✓

107 / 46

St. Pl. Ave. No. 20

Name of Owner

Streeter

Labor and Mat'l. Report Oct 19 1946

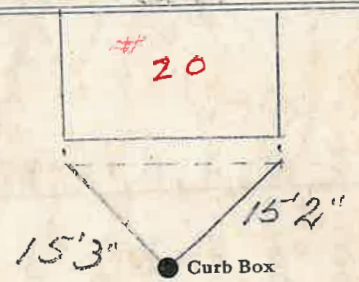

4 Main

Elev. of Main at tap 4½

Gate at ● ● Gate at

TAX ID # 302.12-25-11

● Curb Box

L9M-5C-6-1-45