LABOR AND MATERIALS

1	Copper Lead — Connection	3/4"	$ 3.08
1	Curb — Cock / ~~Valve~~ / ~~T. S. & V.~~	3/4 in.	$ 3.89
	Service box — ~~Old returned~~ — ~~Short 3½ x 4½~~ / Long 4½ x 5½ / Buff or Rdway		$ 4.32
12	Ft. 3/4 in. — Copper / ~~G. I.~~ / ~~C. I.~~ Pipe at 45		$ 5.40
	Nipples in. at		$
	Bushings to in. at		$
	Red'g / Inc'g Coupl'gs to in. at		$
	Union in. at		$
	Meter in. at		$
	Lead Joints at		$
	Compound Joints at		$
	Maintenance Foreman		$ 10.00
	Hrs. Water Maint. Man—1 at		$
	Hrs. Water Maint. Man—2 at		$
3	Hrs. Garage Foreman at	2.033	$ 6.10
3	Hrs. Labor— at	1.30	$ 3.90
	Hrs. Compressor at		$
	Compensation Ins. at $ 5.686 per C		$ .57
	Trucking		$ 1.50
	Pav't Patch		$
Tap by Lawrence Wadleigh 5-18-56			$
			$
			$
	O'head		$
			$ 28.76

Carleton Court ~~St.~~ ~~Pl.~~ Ave. No. 12

Name of Owner

DUNN & STEVENSON

Labor and Mat'l. Report May 18 1956

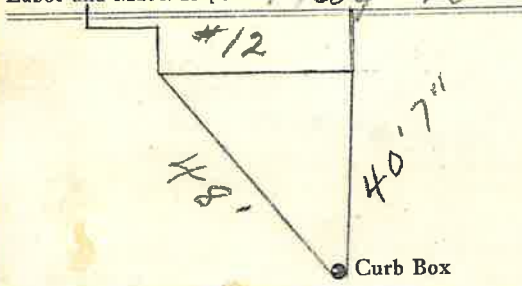

6" Main — Elev. of Main at tap 5'

Gate at • — • Gate at

• Curb Box

L. M—5C—2-1-54