LABOR AND MATERIALS

1 Copper / ~~Lead~~ } Connection 3/4" $

1 Curb { Cock / ~~Valve~~ / ~~T. S. & V.~~ } 3/4 in. $

1 Service box / ~~Old returned~~ { ~~Short 3½ x 4½~~ / ~~Long 4½ x 5½~~ / ~~Buff or Rdway~~ } $

25 Ft. 3/4 in. { Copper / ~~G. I.~~ / ~~C. I.~~ } Pipe at $

Nipples in. at $

Bushings to in. at $

Red'g / Inc'g } Coupl'gs to in. at $

Union in. at $

Meter in. at $

Lead Joints at $

Compound Joints at $

Maintenance Foreman $

Hrs. Water Maint. Man—1 at $

Hrs. Water Maint. Man—2 at $

Hrs. Garage Foreman at $

Hrs. Labor— at $

Hrs. Compressor at $

Compensation Ins. at $ per C $

Trucking $

Pav't Patch $

Tap by Gissord & Co. $

6 - 11/13 - 56. $

$

O'head $

$

Carleton ~~St.~~ ct. ~~Pl.~~ ~~Ave.~~ No. 5

Name of Owner

TAX ID # 309.7-4-15

Labor and Mat'l. Report June 11/13 19 56

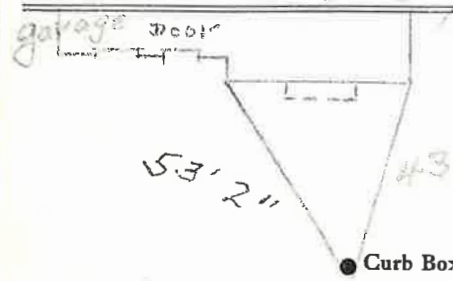

6" Main

Elev. of Main at tap 5-8'

Gate at

Gate at

Curb Box

LSM—5C—3-10-61