LABOR AND MATERIALS

1	Copper / ~~Lead~~ Connection	3/4"	$ 3.08
1	Curb { Cock / ~~Valve~~ / ~~T.S. & V.~~ }	3/4 in.	$ 3.89
1	Service box / ~~Old returned~~ { ~~Short 3½ x 4½~~ / Long 4½ x 5½ / ~~Buff or Rdway~~ }		$ 4.32
11	Ft. 3/4 in. { Copper / ~~C.I.~~ / ~~C.I.~~ } Pipe at	45	$ 4.95
	Nipples in. at		$
	Bushings to in. at		$
	Red'g / Inc'g Coupl'gs to in. at		$
	Union in. at		$
	Meter in. at		$
	Lead Joints at		$
	Compound Joints at		$
	Maintenance Foreman		$
	Hrs. Water Maint. Man—1 at		$
	Hrs. Water Maint. Man—2 at		$
2	Hrs. Garage Foreman at	2.033	$ 4.07
3	Hrs. Labor— at	1.30	$ 3.90
	Hrs. Compressor at		$
	Compensation Ins. at $ 5.686 per C		$ .45
	Trucking		$ 1.50
	Pav't Patch		$
Tap by Lareau + Wadleigh 5-17-56			$
			$
	O'head		$
			$ 26.16

~~St.~~ / ~~Pl.~~ ~~Ave.~~ No. 6

Carleton Court

Name of Owner

Dunn & Stevenson.

Labor and Mat'l. Report May 17 1956

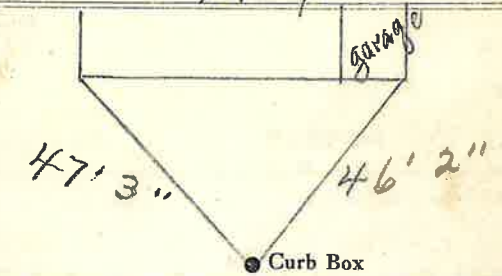

6" Main

Elev. of Main at tap 8'

Gate at ● ● Gate at

● Curb Box

L M—5C—2-1-54