LABOR AND MATERIALS

1	Copper ~~Lead~~ Connection 3/4	$ 1.31
1	Curb {Cock ~~Valve~~ ~~T. S. & V.~~} 3/4 in.	$ 1.75
1	Service Box Old returned {Short 3½x4½ ~~Long 4½x5½~~ ~~Buff. or Rdway~~}	$ 1.60
18	Ft. 3/4 in. {Copper ~~Galv. Iron~~ ~~Cast Iron~~} Pipe at 18	$ 3.24
	~~Nipples~~ in. at	$
	~~Bushings~~ to in. at	$
	~~Red'g~~ ~~Inc'g~~ Couplings to in. at	$
	~~Union~~ in. at	$
	~~Meter~~ in. at	$
	~~Lead~~ Joints at	$
	~~Leadite~~ Joints at	$
	Hrs. Foreman at	$
3	Hrs. Chauffeur at 62½	$ 1.88
8	Hrs. Tapper at	$ 5.00
8	Hrs. Labor at 45	$ 3.60
	Hrs. Labor at	$
	Hrs. Compressor at	$
	Compensation Ins.	$ .31
	Trucking	$ 1.—
	Builders Use of Water Patch	$ 5.—
	Taphy Hassel	$
		$
		$
		$
		$ 24.69

6 2 - - 1940

St.
~~Pl.~~
Charlotte ~~Ave.~~ No. 10-10½

Name of Owner

Simons

Labor and Mat'l. Report July 9 1940

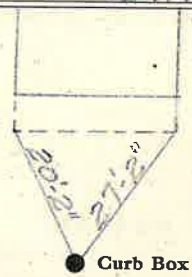

4 Main

Elev. of Main at tap 5—

Gate at ● ● Gate at

● Curb Box