## LABOR AND MATERIALS

| | | | |
|---|---|---|---|
| 1 | Copper / ~~Lead~~ Connection | 3/4" | $ 2.29 |
| 1 | Curb { Cock / ~~Valve~~ / ~~T. S. & V.~~ } | 3/4" in. | $ 2.70 |
| 1 | Service box / Old returned { Short 3½x4½ / ~~Long 4½x5½~~ / Buff or Rdway } | | $ 4.25 |
| 12 | Ft. 3/4 in. { Copper / ~~G. I.~~ / ~~C. I.~~ } Pipe at 35 | | $ 4.20 |
| | Nipples | in. at | $ |
| | Bushings | to in. at | $ |
| | Red'g / Inc'g { Coupl'gs | to in. at | $ |
| | Union | in. at | $ |
| | Meter | in. at | $ |
| | Lead Joints at | | $ |
| | Compound Joints at | | $ |
| 1 | Hrs. Water Maint. Man—1 at | 1.12 | $ 1.12 |
| 2 | Hrs. Water Maint. Man—2 at | 1.02 | $ 2.04 |
| 11 | Hrs. Labor— at | 91 | $ 10.01 |
| | Hrs. Labor— at | | $ |
| | Hrs. Compressor at | | $ |
| | Compensation Ins. at $ per C. | | $ .29 |
| | Trucking | B P. | $ 1.— |
| | Pav't Patch | | $ — |
| | | | $ |
| | | | $ |
| | | | $ |
| | O'head | | $ |
| | | | $ 27.90 |

~~1950~~ Before Paving

St. / Pl. / Ave. No. 13

Charlotte

Name of Owner

Ed. F. Bowers.

Labor and Mat'l. Report July 7 1950

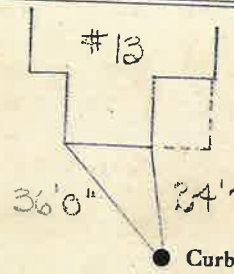


4" Main

Elev. of Main at tap 5'

Gate at ● ● Gate at

● Curb Box

LSM-5C 10-21-49