LABOR AND MATERIALS

1	Copper ~~Lead~~ Connection 3/4	$ 1.35
1	Curb { Cock Valve ~~T. S. & V.~~ } 3/4 in.	$ 1.80
1	Service Box Old returned { ~~Short 3½x4½~~ Long 4½x5½ Buff or Rdway }	$ 1.70
27	Ft. 3/4 in. { Copper Galv Iron ~~Cast Iron~~ } Pipe at 18	$ 4.86
	Nipples ... in. at	$
	Bushings ... to ... in. at	$
	Red'g Inc'g } Couplings ... to ... in. at	$
	Union ... in. at	$
	Meter ... in. at	$
	Lead Joints at	$
	Leadite Joints at	$
	Hrs. Foreman at	$
4	Hrs. Chauffeur at 62½	$ 2.50
16	Hrs. Tapper at	$ 10.—
8	Hrs. Labor at 45	$ 3.60
	Hrs. Labor at	$
1	Hrs. Compressor at .62½	$ .63
	Compensation Ins.	$ .49
	Trucking	$ 1.—
	Builders Use of Water Patch	$ 5.00
	Taylor Hessel	$
		$
		$
		$

$ 33.93

1 2 6 1941

St. 4
~~Pl.~~
Ave. No.

Cherry

Name of Owner

Byrnes

Labor and Mat'l. Report Nov 7 1941

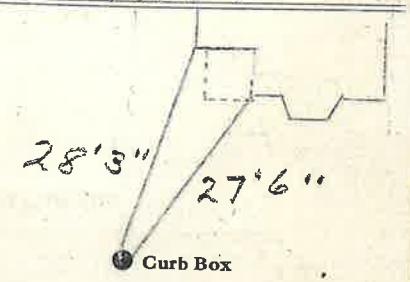

4 Main

Elev. of Main at tap 6

Gate at ●

● Gate at

● Curb Box