LABOR AND MATERIALS

1 Copper / ~~Lead~~ } Connection 3/4" ..... $

1 Curb } Cock / ~~Valve~~ / ~~T. S. & V.~~ } 3/4" in. ..... $

1 Service box / ~~Old returned~~ { Short 3½ x 4½ / ~~Long 4½ x 5½~~ } ..... $

22 Ft. 3/4" in. { Copper / ~~C. I.~~ / ~~C. I.~~ } Pipe at ..... $

..... Nipples ..... in. at ..... $

..... Bushings ..... to ..... in. at ..... $

..... Red'g / Inc'g } Coupl'gs ..... to ..... in. at ..... $

..... Union ..... in. at ..... $

..... Meter ..... in. at ..... $

.... $

..... Compound Joints at ..... $

..... Maintenance Foreman ..... $

..... Hrs. Water Maint. Man—1 at ..... $

..... Hrs. Water Maint. Man—2 at ..... $

..... Hrs. Garage Foreman ..... at ..... $

..... Hrs. Labor— ..... at ..... $

..... Hrs. Compressor at ..... $

..... $

..... Trucking ..... $

..... Pav't Patch ..... $

..... $

..... $

..... $

..... $

..... $

CRN. LAWRENCE + CHERRY

St. / ~~Pl.~~ / ~~Ave.~~ CHERRY No. 28-30

Name of Owner

Labor and Mat'l. Report AUG 1947

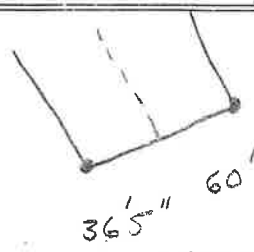

● Curb Box

4" Main Elev. of Main at tap 7'

Gate at ● ● Gate at

● Curb Box

LSM—5C—6-1-67