LABOR AND MATERIALS

1 Copper / ~~Lead~~ } Connection 3/4 ____ $____

1 Curb { Cock / ~~Valve~~ / ~~T. S. & V.~~ } 3/4 in. ____ $____

1 Service box { ~~Short 3½ x 4½~~ / Long 4½ x 5½ } Old returned

____ $____

8 Ft. 3/4 in. { Copper / ~~C. I.~~ / ~~C. I.~~ } Pipe at ____ $____

____ Nipples ____ in. at ____ $____

____ Bushings ____ to ____ in. at ____ $____

____ { Red'g / Inc'g } Coupl'gs ____ to ____ in. at ____ $____

____ Union ____ in. at ____ $____

____ Meter ____ in. at ____ $____

____ ____ $____

____ Compound Joints at ____ $____

____ Maintenance Foreman ____ $____

____ Hrs. Water Maint. Man—1 at ____ $____

____ Hrs. Water Maint. Man—2 at ____ $____

____ Hrs. Garage Foreman ____ at ____ $____

____ Hrs. Labor— ____ at ____ $____

____ Hrs. Compressor at ____ $____

____ $____

____ Trucking ____ $____

____ Pav't Patch ____ $____

____ $____

____ $____

____ $____

____ ____ $____

$____

CHESTER St. / ~~Pl.~~ / ~~Ave.~~ No. 40

Name of Owner

Labor and Mat'l. Report MAY 19 35

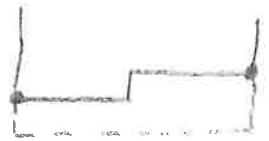

● Curb Box

10" Main Elev. of Main at tap 5[illegible]'

Gate at ● ● Gate at

● Curb Box

LSM—5C—6-1-67