LABOR AND MATERIALS

1 Copper / ~~Lead~~ Connection ____ $____

1 Curb ~~Cock~~ / ~~Valve~~ / ~~T. S. & V.~~ ____ in. ____ $____

1 Service box Old returned ~~Short 3½ x 4½~~ / Long 4½ x 5½ / ~~Buff or Rdway~~ ____ $____

18 Ft. 3/4 in. Copper / ~~G. I.~~ / ~~C. I.~~ Pipe at ____ $____

____ Nipples ____ in. at ____ $____

____ Bushings ____ to ____ in. at ____ $____

____ Red'g / Inc'g Coupl'gs ____ to ____ in. at ____ $____

____ Union ____ in. at ____ $____

____ Meter ____ in. at ____ $____

____ Lead Joints at ____ $____

____ Compound Joints at ____ $____

____ Maintenance Foreman ____ $____

____ Hrs. Water Maint. Man—1 at ____ $____

____ Hrs. Water Maint. Man—2 at ____ $____

____ Hrs. Garage Foreman ____ at ____ $____

____ Hrs. Labor— ____ at ____ $____

____ Hrs. Compressor at ____ $____

____ Compensation Ins. at $____ per C ____ $____

____ Trucking ____ $____

____ Pav't Patch ____ $____

____ $____

____ $____

____ $____

____ O'head ____ $____

$____

~~St.~~
~~Pl.~~

CLINTON Ave. No. 7

Name of Owner

Labor and Mat'l. Report 19

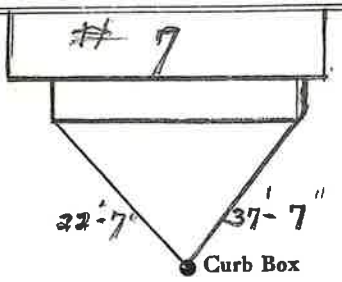

4 Main Elev. of Main at tap 5

Gate at ● ● Gate at

● Curb Box

LSM—5C—6-1-67