1 4 - - 1940

St.
Pl.
Coolidge Ave. No. 72

Name of Owner

Silverman

Labor and Mat'l. Report April 25 1940

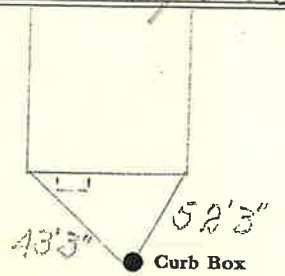

6 Main

Elev. of Main at tap 5

Gate at ●

● Gate at

● Curb Box

72

LABOR AND MATERIALS

1 Copper ~~Lead~~ } Connection 3/4 ..... $ 1.31

1 Curb { Cock ~~Valve~~ ~~T. C. & V.~~ } 3/4 in. ..... $ 1.75

1 Service Box ~~Old returned~~ { Short 3½x4½ ~~Long 4½x5½~~ ~~Buff. or Redwy~~ } ..... $ 1.60

6 Ft. 3/4 in. { Copper ~~Galv. Iron~~ ~~Cemtiron~~ } Pipe at 18 $ 1.08

..... Nipples ..... in. at ..... $ .....

..... Bushings ..... to ..... in. at ..... $ .....

..... Red'g Inc'g } Couplings ..... to ..... in. at ..... $ .....

..... Union ..... in. at ..... $ .....

..... Meter ..... in. at ..... $ .....

..... Lead Joints at ..... $ .....

..... Leadite Joints at ..... $ .....

..... Hrs. Foreman at ..... $ .....

2 Hrs. Chauffeur at 62½ ..... $ 1.25

5 Hrs. Tapper at ~~7~~ ..... $ 5.00

4 Hrs. Labor at 45 ..... $ 1.80

..... Hrs. Labor at ..... $ .....

2 Hrs. Compressor at 62½ ..... $ 1.25

..... Compensation Ins. ..... $ .25

..... Trucking ..... $ 1.—

..... Builders Use of Water ½ Patch Sewer $ 2.50

Trophy Store ..... $ .....

..... $ .....

..... $ .....

..... $ .....

$ 18.79