31 - - 1939

~~St.~~
~~Pl.~~

Coolidge Ave. No. 92

Name of Owner

P.F. Marrs

Labor and Mat'l. Report June 28 1939

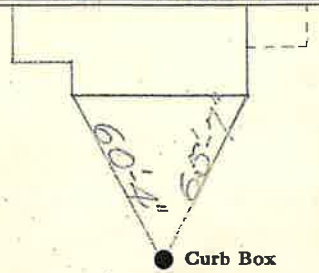

12 Main

Elev. of Main at tap 5 -

Gate at ●

● Gate at

Think this house is in Queensbury + all nos. after it

Nan Hess.

LABOR AND MATERIALS

1	Copper ~~Lead~~ Connection 3/4	$ 1.23
1	Curb Cock ~~Valve~~ ~~T. S. & V.~~ 3/4 in.	$ 1.68
1	Service Box ~~Old returned~~ Short 3½x4½ ~~Long 4½x5½~~ ~~Buff. or Rdway~~	$ 1.54
10	Ft. 3/4 in. Copper ~~Galv Iron~~ ~~Cast Iron~~ Pipe at 17	$ 1.70
	Nipples in. at	$
	Bushings to in. at	$
	Red'g Inc'g Couplings to in. at	$
	Union in. at	$
	Meter in. at	$
	Lead Joints at	$
	Leadite Joints at	$
	Hrs. Foreman at	$
	Hrs. Chauffeur at	$
3	Hrs. Tapper at 62½	$ 1.88
3	Hrs. Labor at .45	$ 1.35
	Hrs. Labor at	$
	Hrs. Compressor at	$
	Compensation Ins.	$ 10
	Trucking	$ 1 —
	Builders Use of Water no patch (outside)	$ —
	Tap by Hessel	$
		$
		$
		$
		$ 10 48

26