LABOR AND MATERIALS

1 Copper / ~~Lead~~ } Connection 3/4 $

1 Curb { Cock / Valve / T. S. & V. } 3/4 in. $

1 Service box / Old returned { ~~Short 3½ x 4½~~ / Long 4½ x 5½ } $

9 Ft. 3/4 in. { Copper / ~~C. I.~~ / ~~C. I.~~ } Pipe at $

Nipples in. at $

Bushings to in. at $

Red'g / Inc'g } Coupl'gs to in. at $

Union in. at $

Meter in. at $

$

Compound Joints at $

Maintenance Foreman $

Hrs. Water Maint. Man—1 at $

Hrs. Water Maint. Man—2 at $

Hrs. Garage Foreman at $

Hrs. Labor— at $

Hrs. Compressor at $

$

Trucking $

Pav't Patch $

$

$

$

$

$

COOLIDGE ~~St.~~ ~~Pl.~~ Ave. No. 9

Name of Owner

Labor and Mat'l. Report MAY 14 1929

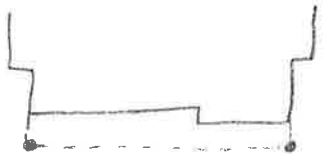

● Curb Box

6" Main

Elev. of Main at tap 5' ~

Gate at ●

● Gate at

● Curb Box

OLD TAP SHUT OFF

LSM—5C—6-1-67