LABOR AND MATERIALS

1	Copper ~~Lead~~ Connection 3/4		$ 2.80
1	Curb {Clock ~~Valve~~ ~~T. S. & V.~~} 3/4 in.		$ 3.60
1	Service box Old returned {Short 3½X4½ ~~Long 4½X5½~~ ~~Buff or Rdway~~}		$ 5.80
15	Ft. 3/4 in. {Copper ~~Galv. Iron~~ ~~Cast Iron~~} Pipe at 35		$ 5.35
1	Nipples 3/4 in. at 3" long		$
	Bushings to in. at		$
1	Red'g Inc'g Couplings 3/4 to 1" in. at		$
	Union in. at		$
	Meter in. at		$
	Lead Joints at		$
	Compound Joints at		$
	Hrs. Foreman at		$
12	Hrs. ~~Chauffeur at~~ WMM②	91	$ 10.92
	Hrs. Tapper at		$
16	Hrs. Labor at	80	$ 12.80
	Hrs. Labor at		$
1	Hrs. Compressor at	87½	$ .88
	Compensation Ins.		$ .52
	Trucking		$ 1.00
	Builders Use of Water		$ 4.70
	Tap by Warsinski		$
			$
			$
			$
			$ 48.37

23.72

115/47

Cooper St. ~~Pl.~~ ~~Ave.~~ No. 30

Name of Owner

Son of Italy

Labor and Mat'l. Report July 19 1947

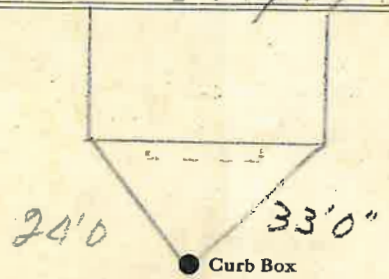

6 Main Elev. of Main at tap 5

Gate at ● ● Gate at

TAX ID # 303.17-3-2

● Curb Box

LSM-5C-6-1-45 (to be Charge)