LABOR AND MATERIALS

1 Copper / ~~Lead~~ } Connection 3/4 $

1 Curb { Cock / Valve / ~~T. S. & V.~~ } 3/4 in. $

1 Service box / ~~Old returned~~ { ~~Short 3½ x 4½~~ / Long 4½ x 5½ } $

8 Ft. 3/4 in. { Copper / ~~C. I.~~ / ~~C. I.~~ } Pipe at $

Nipples in. at $

Bushings to in. at $

Red'g / Inc'g } Coupl'gs to in. at $

Union in. at $

Meter in. at $

$

Compound Joints at $

Maintenance Foreman $

Hrs. Water Maint. Man—1 at $

Hrs. Water Maint. Man—2 at $

Hrs. Garage Foreman at $

Hrs. Labor— at $

Hrs. Compressor at $

$

Trucking $

Pav't Patch $

$

$

$

$

$

COOPER St. / ~~Pl.~~ / ~~Ave.~~ No. 92

Name of Owner

TAX ID # 303.13-9-4

Labor and Mat'l. Report NOV 28 1927

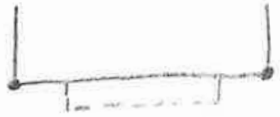

39' 5" 35' 6"

● Curb Box

4" Main

Elev. of Main at tap 5'

Gate at ●

● Gate at

● Curb Box

NEW TAP
NEW HOUSE

LSM—5C—6-1-67