LABOR AND MATERIALS

1	Copper ~~Lead~~ Connection	3/4	$ 1.78
1	Curb { Clock ~~Valve~~ ~~T. S. & V.~~ }	3/4 in.	$ 2.61
1	Service box Old returned { Short 3½X4½ ~~Long 4½X5½~~ ~~Buff or Rdway~~ }		$ 1.82
12	Ft. 3/4 in. { Copper ~~Galv. Iron~~ ~~Cast Iron~~ } Pipe at 2		$ 2.76
	Nipples in. at		$
	Bushings to in. at		$
	Red'g Inc'g } Couplings to in. at		$
	Union in. at		$
	Meter in. at		$
	Lead Joints at		$
	Compound Joints at		$
	Hrs. Foreman at		$
	Hrs. Chauffeur at		$
5	Hrs. Tapper at	.75	$ 3.75
5	Hrs. Labor at	.65	$ 3.25 7.00
	Hrs. Labor at		$
	Hrs. Compressor at		$
	Compensation Ins.		$ 19
	Trucking		$ 1.00
	Builders Use of Water.	2	$ 5.00
	Taply Moquinn		$
			$
			$
			$
			$ 22.16

✓

21-146

Cooper
~~Sanford~~

St. ~~Pl.~~ ~~Ave.~~ No. 122 ~~98~~

Name of Owner

Rhodes

Labor and Mat'l. Report Apl 29 1946

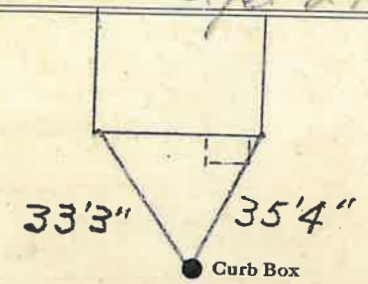

6 Main

Elev. of Main at tap 4

Gate at ●

● Gate at

TAX ID # 303.13-3-4

● Curb Box

LSM-5C-6-1-45