LABOR AND MATERIALS

1	Copper / ~~Lead~~	Connection	3/4	$ 2.94
1	Curb	Cock / ~~Valve~~ / ~~T. S. & V.~~	3/4 in.	$ 3.71
1	Service box	Old returned: Short 3½X4½ / ~~Long 4½X5½~~ / Buff or Rdway		$ 5.90
19 Ft.	3/4 in.	Copper / ~~G. I.~~ / ~~C. I.~~	Pipe at 30	$ 5.70
	Nipples	in. at		$
	Bushings	to in. at		$
	Red'g / Inc'g	Coupl'gs to in. at		$
1	Union	in. at		$
	Meter	in. at		$
	Lead Joints at			$
	Compound Joints at			$
	Hrs. Water Maint. Man—1 at			$
N	Hrs. Water Maint. Man—2 at		1.02	$ 2.04
16	Hrs. Labor—	at	91	$ 14.56
	Hrs. Labor—	at		$
	Hrs. Compressor at			$
	Compensation Ins. at $	per C		$ .37
	Trucking			$ .10
	Pav't Patch			$ 16.00
	Top by Macasmustic			$
				$
	O'head			$
				$ 52.22

148

St.
Pl.
Ave. No. 12½

Name of Owner

Clarke

Labor and Mat'l. Report Nov 1 1948

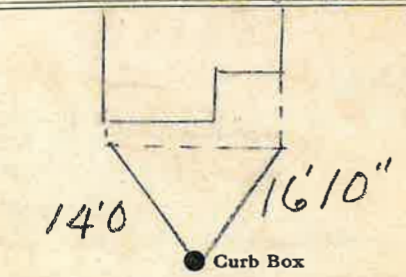

6" Main

Elev. of Main at tap 5'

Gate at ● ● Gate at

19' to main

● Curb Box

Tax Map #309.7-6-6

LSM-5C 5 15-48