## LABOR AND MATERIALS

1 Copper / ~~Lead~~ } Connection 3/4" $____

1 Curb { Cock / ~~Valve~~ / ~~T. S. & V.~~ } 3/4 in. Oriseal $____

1 Service box { Short 3½ x 4½ / ~~Long 4½ x 5½~~ / ~~Buff or Rdway~~ } Old returned $____

16 Ft. 3/4 in. { Copper / ~~G. I.~~ / ~~C. I.~~ } Pipe at $____

____ Nipples ____ in. at $____

____ Bushings ____ to ____ in. at $____

____ Red'g / Inc'g } Coupl'gs ____ to ____ in. at $____

____ Union ____ in. at $____

____ Meter ____ in. at $____

____ Lead Joints at $____

____ Compound Joints at $____

____ Maintenance Foreman $____

____ Hrs. Water Maint. Man—1 at $____

____ Hrs. Water Maint. Man—2 at $____

____ Hrs. Garage Foreman ____ at $____

____ Hrs. Labor— ____ at $____

____ Hrs. Compressor at $____

____ Compensation Ins. at $____ per C $____

____ Trucking $____

____ Pav't Patch $____

Tap by Lareau + Co. $____

$____

Nov. 17-70. $____

____ O'head $____

$____

$____

Grandall St. / ~~Pl.~~ / ~~Ave.~~ No. 24

Name of Owner

Labor.

Labor and Mat'l. Report Nov. 17 1970

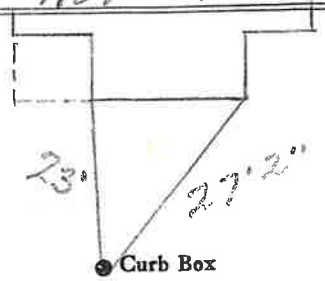


10" Main Elev. of Main at tap 5'

Gate at • • Gate at

• Curb Box

LSM—5C—6-1-67