CRANDALL St. ~~Pl.~~ ~~Ave.~~ No. 50

Name of Owner

Labor and Mat'l. Report SEPT 23 1924

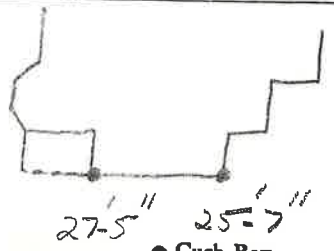

● Curb Box

10" Main

Elev. of Main at tap 4'

Gate at ●

● Gate at

● Curb Box

LSM—5C—6-1-67

LABOR AND MATERIALS

1 ~~Copper~~ Lead } Connection 3/4 $

1 Curb { Cock ~~Valve~~ ~~T. S. & V.~~ } 1" in. $

1 Service box { Short 3½ x 4½ ~~Long 4½ x 5½~~ } Old returned $

19 Ft. 1" in. { ~~Copper~~ G. I. ~~C. I.~~ } Pipe at $

Nipples in. at $

1 Bushings ½ to 1" in. at $

Red'g Inc'g } Coupl'gs to in. at $

Union in. at $

Meter in. at $

$

Compound Joints at $

Maintenance Foreman $

Hrs. Water Maint. Man—1 at $

Hrs. Water Maint. Man—2 at $

Hrs. Garage Foreman at $

Hrs. Labor— at $

Hrs. Compressor at $

$

Trucking $

Pav't Patch $

$

$

$

$