Labor and Materials

1	Lead Connection	$
1	Curb Cock	$
1	Service Box, Old returned { Short 3½ x 4 / Long 4½ x 5½ / Buffalo }	$
16	Ft. 1 in. G. I. Pipe at	$
	Nipples in. at	$
	Bushings to in. at	$
	Red'g Coup to in. at	$
	Inc'g Coup to in. at	$
	Union in. at	$
	Meter in. at	$
	Cu. Yds. Br. Stone at	$
	Cu. Yds. Sand at	$
	Bags Cement at	$
	Paving Brick { Mack / Red / Asphalt } at	$
2	Hrs. Foreman at	$
3	Hrs. Common Labor at	$
	Hrs. Mason at	$
	Hrs. at	$
	Hrs. at	$
90	Builders' Use of Water	$
	at	$
Truck 1.50	at	$
	at	$
	at	$
	Total	$ 11.91

Labor and Material Report 19

August 4

70 Crandall St.

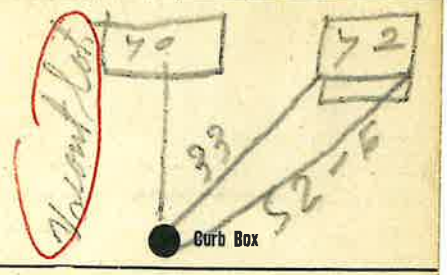

10 Main

Elev. of Main at tap 4

Gate at ● ● Gate at

● Curb Box