Labor and Materials

1	Lead Connection 3/4	$
1"	Curb Cock 1"	$
1	Service Box Old returned { ~~Short 3½ x 4½~~ Long 4½ x 5½ Buffalo	$
17	Ft. 1 in. G. I. Pipe at	$
	Nipples ..... in. at	$
	Bushings ..... to ..... in. at	$
	Red'g Coup .... to .... in. at	$
	Inc'g Coup .... to .... in. at	$
	Union .... in. at	$
	Meter .... in. at	$
	Cu. Yds. Br. Stone at	$
	Cu. Yds. Sand at	$
	Bags Cement at	$
	Paving Brick { Mack Red Asphalt } at	$
5	Hrs. Foreman at	$
17	Hrs. Common Labor at	$
	Hrs. Mason at	$
	Hrs. ..... at	$
	Hrs. ..... at	$
900	Builders' Use of Water	$
	..... at	$
	Truck 100 ..... at	$
	..... at	$
	..... at	$
	Total	$ 19.08

Labor and Material Report Oct 4 19..

3/4 tap at 10 Lorandell st

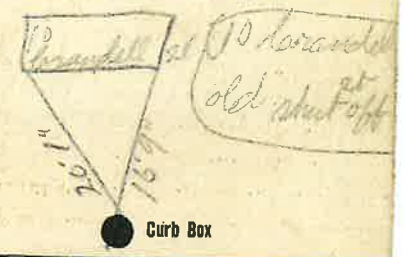

8" Main

Elev. of Main at tap 4 ft

Gate at ●

● Gate at

● Curb Box