LABOR AND MATERIALS

1 Copper ~~Lead~~ } Connection ..... $ 1.31

1 Curb { Cock / ~~Valve~~ / ~~T. S. & V.~~ } 3/4 in. ..... $ 1.75

1 Service Box ~~Old returned~~ { Short 3½x4½ / ~~Long 4½x5½~~ / ~~Buff. or Rdway~~ } ..... $ 1.60

8 3/4 Ft. ..... in. { Copper / ~~Galv. Iron~~ / ~~Cast Iron~~ } Pipe at 18 $ 1.44

..... Nipples ..... in. at ..... $.....

..... Bushings ..... to ..... in. at ..... $.....

..... Red'g / Inc'g } Couplings ..... to ..... in. at ..... $.....

..... Union ..... in. at ..... $.....

..... Meter ..... in. at ..... $.....

..... Lead Joints at ..... $.....

..... Leadite Joints at ..... $.....

..... Hrs. Foreman at ..... $.....

1 1/2 Hrs. Chauffeur at 6.2½ ..... $ .94

2 3/4 Hrs. Tapper at " ..... $ 1.72

8 Hrs. Labor at .45 ..... $ 3.60

..... Hrs. Labor at ..... $.....

..... Hrs. Compressor at ..... $.....

..... Compensation Ins. ..... $ .19

..... Trucking ..... $ 1.—

..... Builders Use of Water ..... $.....

Taplyn Hessel ..... $.....

..... $.....

..... $.....

..... $.....

$ 13.55

1 5 5 - 1940

St. ~~Pl.~~ 15

Culvert Ave. No. 11

Name of Owner

Hot
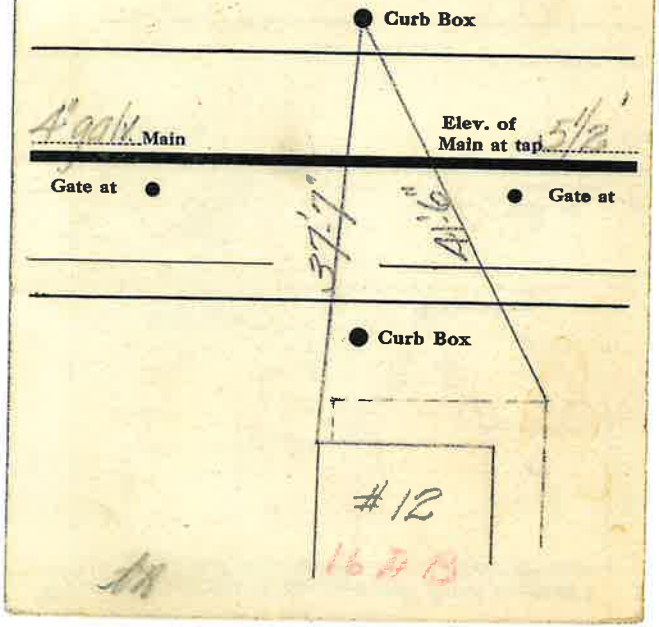
Labor and Mat'l. Report OCT 18 1940 19