LABOR AND MATERIALS

1 Copper / ~~Lead~~ Connection 3/4 ..... $ 2.87

1 Curb { Cock / ~~Valve~~ / ~~T. S. & V.~~ } 3/4 in. ..... $ 3.62

1 Service box ~~Old-returned~~ { ~~Short 3½X4½~~ / Long 4½X5½ / ~~Buff or Redway~~ } ..... $ 4.68

26 Ft. 3/4 in. { Copper / ~~C. I.~~ / ~~C. I.~~ } Pipe at 32 ..... $ 8.32

..... Nipples ..... in. at ..... $ .....

..... Bushings ..... to ..... in. at ..... $ .....

..... Red'g / Inc'g { Coupl'gs ..... to ..... in. at ..... $ .....

..... Union ..... in. at ..... $ .....

..... Meter ..... in. at ..... $ .....

..... Lead Joints at ..... $ .....

..... Compound Joints at ..... $ .....

..... Hrs. Water Maint. Man—1 at ..... $ .....

5/2 Hrs. Water Maint. Man—2 at ... 1.02 $ 5.10

..... Hrs. Labor— ....at ..... 91 $ 1.82

..... Hrs. Labor— ....at ..... $ .....

..... Hrs. Compressor at ..... $ .....

..... Compensation Ins. at $ 2.18 per C ..... $ .15

..... Trucking ..... $ 2.00

..... Pav't Patch ..... $ 10.25

Top by Magnum ..... $ .....

..... $ .....

..... $ .....

..... O'head ..... $ .....

$ 38.81

76

~~St.~~ 23
~~Pl.~~

Cunningham Ave. No. ~~15~~

Name of Owner

Wells

Labor and Mat'l. Report July 18 1949

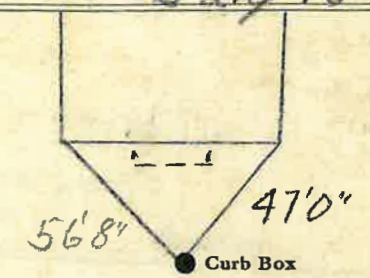

6" Main

Elev. of Main at tap 5'

Gate at ●

● Gate at

TAX ID # 302.19-2-25

● Curb Box

LSM-5C 5 15-48