LABOR AND MATERIALS

1	Copper ~~Lead~~ Connection 3/4	$ 1.31
1	Curb { Cock ~~Valve~~ ~~T. S. & V.~~ } 3/4 in.	$ 1.75
1	Service Box ~~Old returned~~ { ~~Short 3½x4½~~ Long 4½x5½ ~~Buff. or Rdway~~ }	$ 1.60
26 Ft. 3/4 in.	{ Copper ~~Galv. Iron~~ ~~Cast Iron~~ } Pipe at 18	$ 4.68
	Nipples ____ in. at	$
	Bushings ____ to ____ in. at	$
	Red'g Inc'g } Couplings ____ to ____ in. at	$
	Union ____ in. at	$
	Meter ____ in. at	$
	Lead Joints at	$
	Leadite Joints at	$
	Hrs. Foreman at	$
5	Hrs. Chauffeur at 62½	$ 3.12
3	Hrs. Tapper at 4	$ 1.88
10	Hrs. Labor at 45	$ 4.50
	Hrs. Labor at	$
	Hrs. Compressor at	$
	Compensation Ins.	$ .29
	Trucking	$ 1.—
	Builders Use of Water ½ Patch (Sewer)	$ 2.50
	Tap by Penon	$
		$
		$
		$
		$ 22.63

Lots 17-18

8 - - 1940 ~~St.~~ ~~Pl.~~ 37

Cunningham Ave. No. 27

Name of Owner

Rosoff

Labor and Mat'l. Report June 25 1940

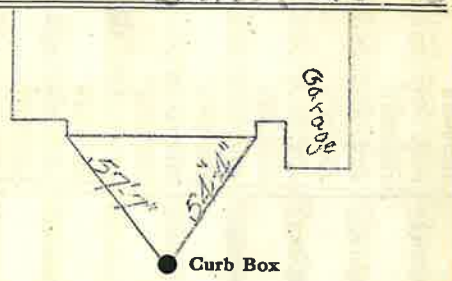

6 Main — Elev. of Main at tap 5

Gate at ● ● Gate at

● Curb Box

New House