## LABOR AND MATERIALS

| | | | |
|---|---|---|---|
| 1 | Copper / ~~Lead~~ Connection | 3/4 | $ 2.87 |
| 1 | Curb ~~Valve~~ Cock / ~~T. S. & V.~~ | 3/4 in. | $ 3.62 |
| 1 | Service box Old returned ~~Short 3½X4½~~ / Long 4½X5½ / ~~Buff or Rdway~~ | | $ 4.68 |
| 25 | Ft. 3/4 in. ~~C. I.~~ / ~~C. I.~~ Copper Pipe at | 32 | $ 8.00 |
| | Nipples ..... in. at | | $ |
| | Bushings ..... to ..... in. at | | $ |
| | Red'g Inc'g Coupl'gs ..... to ..... in. at | | $ |
| | Union ..... in. at | | $ |
| | Meter ..... in. at | | $ |
| | Lead Joints at | | $ |
| | Compound Joints at | | $ |
| | Hrs. Water Maint. Man—1 at | | $ |
| 3 | Hrs. Water Maint. Man—2 at | 1.02 | $ 3.06 |
| 4 | Hrs. Labor— ....at | 91 | $ 3.64 |
| | Hrs. Labor— ....at | | $ |
| | Hrs. Compressor at | | $ |
| | Compensation Ins. at $2.18 per C | | $ .15 |
| | Trucking | | $ 2.00 |
| | Pav't Patch | | $ 10.25 |
| | Tag Application | | $ |
| | | | $ |
| | | | $ |
| | O'head | | $ |
| | | | $ 38.27 |

100

~~St.~~ ~~Pl.~~

Cunningham Ave. No. 43

**Name of Owner**

~~Miss~~ Mrs Muster

**Labor and Mat'l. Report** Sept 26 1949

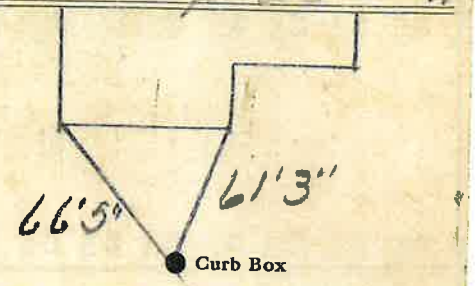


5 Main

Elev. of Main at tap 5"

Gate at ● ● Gate at

● Curb Box

LSM-SC 5 15-48